


LOCUS MAP (N.T.S.)

INTERSTATE 395 (FORMERLY ROUTE 52) 1968 S.H.L.O. NO. 5782 (LIMITED ACCESS)

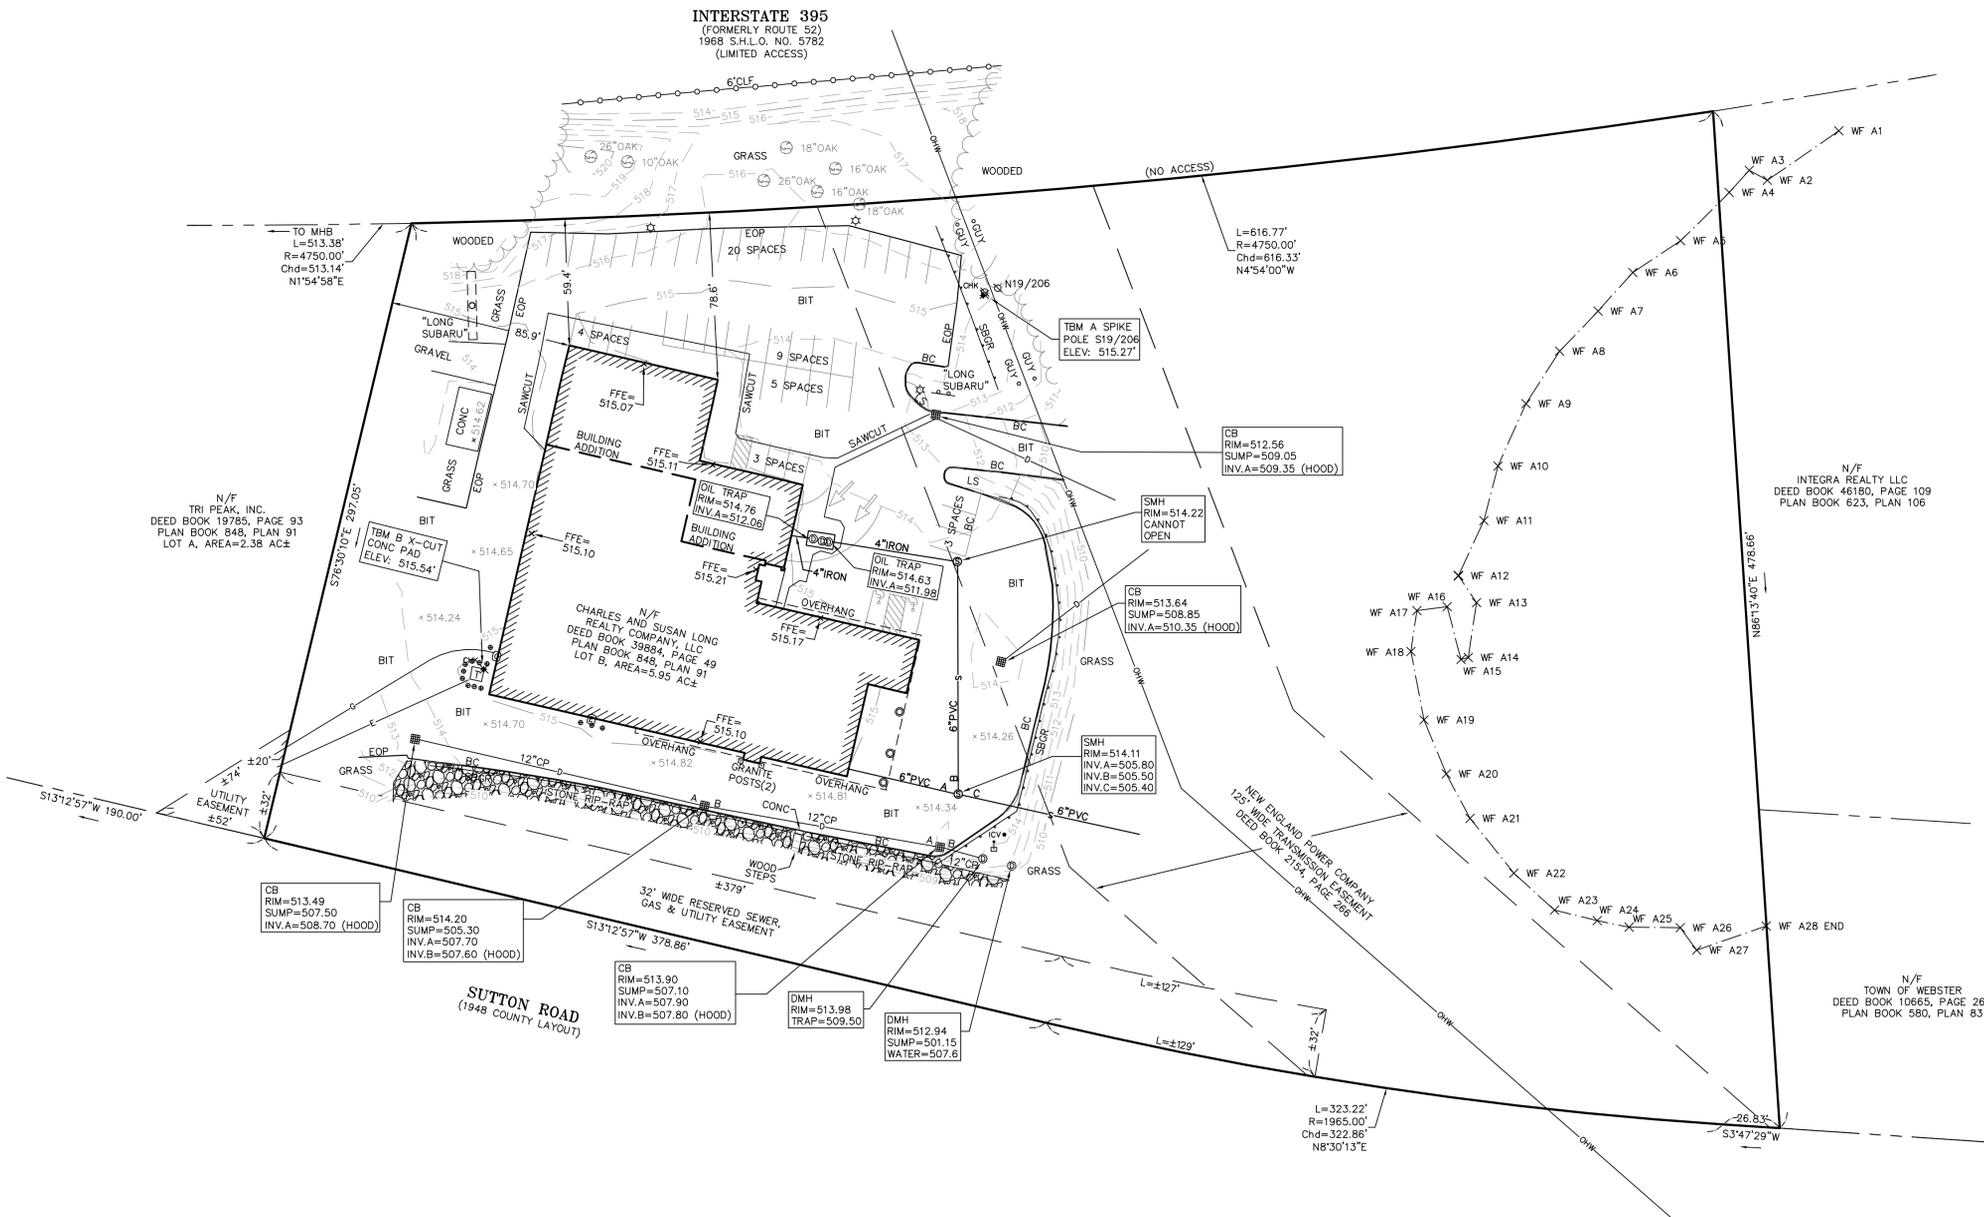


- LEGEND: CATCH BASIN, DRAIN MANHOLE, SEWER MANHOLE, ELECTRIC METER, GAS METER, PAD MOUNT ELECTRIC TRANSFORMER, IRRIGATION CONTROL VALVE, UTILITY POLE, DECIDUOUS TREE, SIGN (DOUBLE POSTED), PYLON SIGN (SINGLE POSTED), POST, LIGHT POLE, BOLLARD, FLAG POLE, HANDICAP PARKING, COLUMN, TEMPORARY BENCHMARK, MASS. HIGHWAY STONE BOUND, STEEL BEAM GUARD RAIL, BITUMINOUS CURB, BITUMINOUS PAVEMENT, CONCRETE PAVEMENT, EDGE OF PAVEMENT, LANDSCAPED AREA, FINISHED FLOOR ELEVATION, CORRUGATED PLASTIC PIPE, POLYVINYL CHLORIDE, INVERT, ABUTTERS LOT LINE, PROPERTY LINE, EASEMENT, CHAIN LINK FENCE, STEEL BEAM GUARD RAIL, SEWER LINE, DRAIN LINE, GAS LINE, UNDERGROUND ELECTRIC, OVERHEAD WIRES, TREE LINE, INTERMEDIATE CONTOURS, INDEX CONTOURS, WETLAND LINE.

- PLAN REFERENCES: 1. 1968 S.H.L.O. NO. 5782, 2. PLAN BOOK 459, PLAN 119, 3. PLAN BOOK 580, PLAN 83, 4. PLAN BOOK 623, PLAN 106, 5. PLAN BOOK 848, PLAN 91

UTILITY STATEMENTS: THE LOCATION OF THE UTILITIES AS SHOWN HEREON ARE FROM VISIBLE STRUCTURES ONLY. NO OTHER RECORD INFORMATION WAS OBTAINED FROM ANY SOURCES. THE ACTUAL LOCATION OF ALL UTILITIES AND UNDERGROUND STRUCTURES SHALL BE CONSIDERED APPROXIMATE AND SHALL BE VERIFIED BY THE OWNER PRIOR TO ANY CONSTRUCTION.

- NOTES: 1. THIS PLAN WAS PREPARED FROM AN ACTUAL ON THE GROUND FIELD SURVEY CONDUCTED BY WSP DURING FEBRUARY 2 AND MARCH OF 2016 AND AGAIN DURING DECEMBER OF 2018 TO AS-BUILT THE BUILDING ADDITION AND PARKING RE-STRIPING. 2. THE HORIZONTAL DATUM SHOWN HEREON IS THE MASSACHUSETTS STATE COORDINATE GRID, MAINLAND ZONE, NORTH AMERICAN DATUM OF 1983 (NAD-83). 3. THE VERTICAL DATUM SHOWN HEREON REFERENCES NORTH AMERICAN VERTICAL DATUM OF 1983 (NAVD-88). 4. WETLANDS WERE FLAGGED BY WILLIAMS & SPARGES ENGINEERS OF MIDDLETON, MA, AT THE DIRECTION OF HOWARD STEIN HUDSON DURING THE WEEK ENDING FEBRUARY 25, 2016, AND SUBSEQUENTLY LOCATED BY WSP. 5. CATCH BASIN ELIMINATOR HOODS WERE INSTALLED ON OUTLET PIPES DURING APRIL OF 2019.

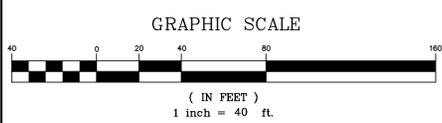

CERTIFICATION:



DAVID P. PRINCE, P.L.S. REG. NO. 52328 WSP USA, Inc. 04/15/19

REVISION table with columns for DATE and DESCRIPTION. Entry: 04/10/19 ADDED CATCH BASIN ELIMINATOR HOOD NOTE #5

AS-BUILT PLAN 7 SUTTON ROAD WEBSTER, MASSACHUSETTS PREPARED FOR HOWARD STEIN HUDSON



Table with columns: Drawn By (CG), Date (DECEMBER 17, 2018), Job No. (188710Y), Checked By (DPP), Scale (1" = 40'), Sheet No. (1 OF 1), Book No. (N-292)

188710Y-1 rev1.dwg